


SHRUB SCHEDULE			
EVERGREEN SHRUBS	QTY	BOTANICAL / COMMON NAME	CONT
	21	JUNIPERUS SABINA 'BUFFALO' / BUFFALO JUNIPER	5 GAL.
LARGE SHRUB	QTY	BOTANICAL / COMMON NAME	CONT
	16	CHRYSOTHAMNUS NAUSEOSUS / RUBBER RABBITBRUSH	5 GAL.
	22	CORNUS SERICEA / RED TWIG DOGWOOD	5 GAL.
	10	RHUS TRILOBATA / THREE LEAF SUMAC	5 GAL.
MEDIUM SHRUB	QTY	BOTANICAL / COMMON NAME	CONT
	30	CERCOCARPUS INTRICATUS / LITTLELEAF MOUNTAIN MAHOGONY	5 GAL.
	38	FALLUGIA PARADOXA / APACHE PLUME	5 GAL.
	23	OLIGOSPORUS FILIFOLIUS / SAND SAGEBRUSH	5 GAL.
	24	YUCCA FILAMENTOSA / ADAM'S NEEDLE	5 GAL.
ORNAMENTAL GRASSES	QTY	BOTANICAL / COMMON NAME	CONT
	31	BOUTELOUA GRACILIS / BLUE GRAMA GRASS	1 GAL.
	49	SCHIZACHYRIUM SCOPARIUM / LITTLE BLUESTEM	1 GAL.
SMALL SHRUB	QTY	BOTANICAL / COMMON NAME	CONT
	51	PEROVSKIA ATRIPLICIFOLIA / RUSSIAN SAGE	5 GAL.

TREE SCHEDULE				
DECIDUOUS TREE	QTY	BOTANICAL / COMMON NAME	CONT	SIZE
	2	ACER GRANDIDENTATUM / BIGTOOTH MAPLE	B&B	3" CAL.
	4	CRATAEGUS AMBIGUA / RUSSIAN HAWTHORN	B&B	10' CLUMP
EVERGREEN TREES	QTY	BOTANICAL / COMMON NAME	CON	SIZE
	7	PINUS EDULIS / PINON PINE	B&B	12'

LEGEND:

- SS SANITARY SEWER
- CULVERT
- OHE OVERHEAD ELECTRIC
- UGE UNDERGROUND ELECTRIC
- W WATER
- IRR IRRIGATION
- FO FIBER OPTIC
- SANITARY SEWER MANHOLE
- STORM MANHOLE
- ELECTRIC METER
- ELECTRIC BOX
- ELECTRIC GROUND POLE
- ELECTRIC MANHOLE
- ELECTRIC TRANSFORMER OR VAULT
- ELECTRIC POLE
- ELECTRIC LIGHT
- TRAFFIC SIGNAL ARM
- WATER VALVE
- FIRE HYDRANT
- IRRIGATION VALVE
- TELEPHONE MANHOLE
- TELEPHONE OR FIBER OPTIC PEDESTAL OR VAULT
- SEEDING TYPE 1 (NATIVE)
- SEEDING TYPE 2 (NATIVE)
- ROCK MULCH (RIVER COBBLE)
- CONCRETE MEDIAN COVER
- PLANTING BED (LANDSCAPE FABRIC, MULCH AND PLANTINGS)
- SOD

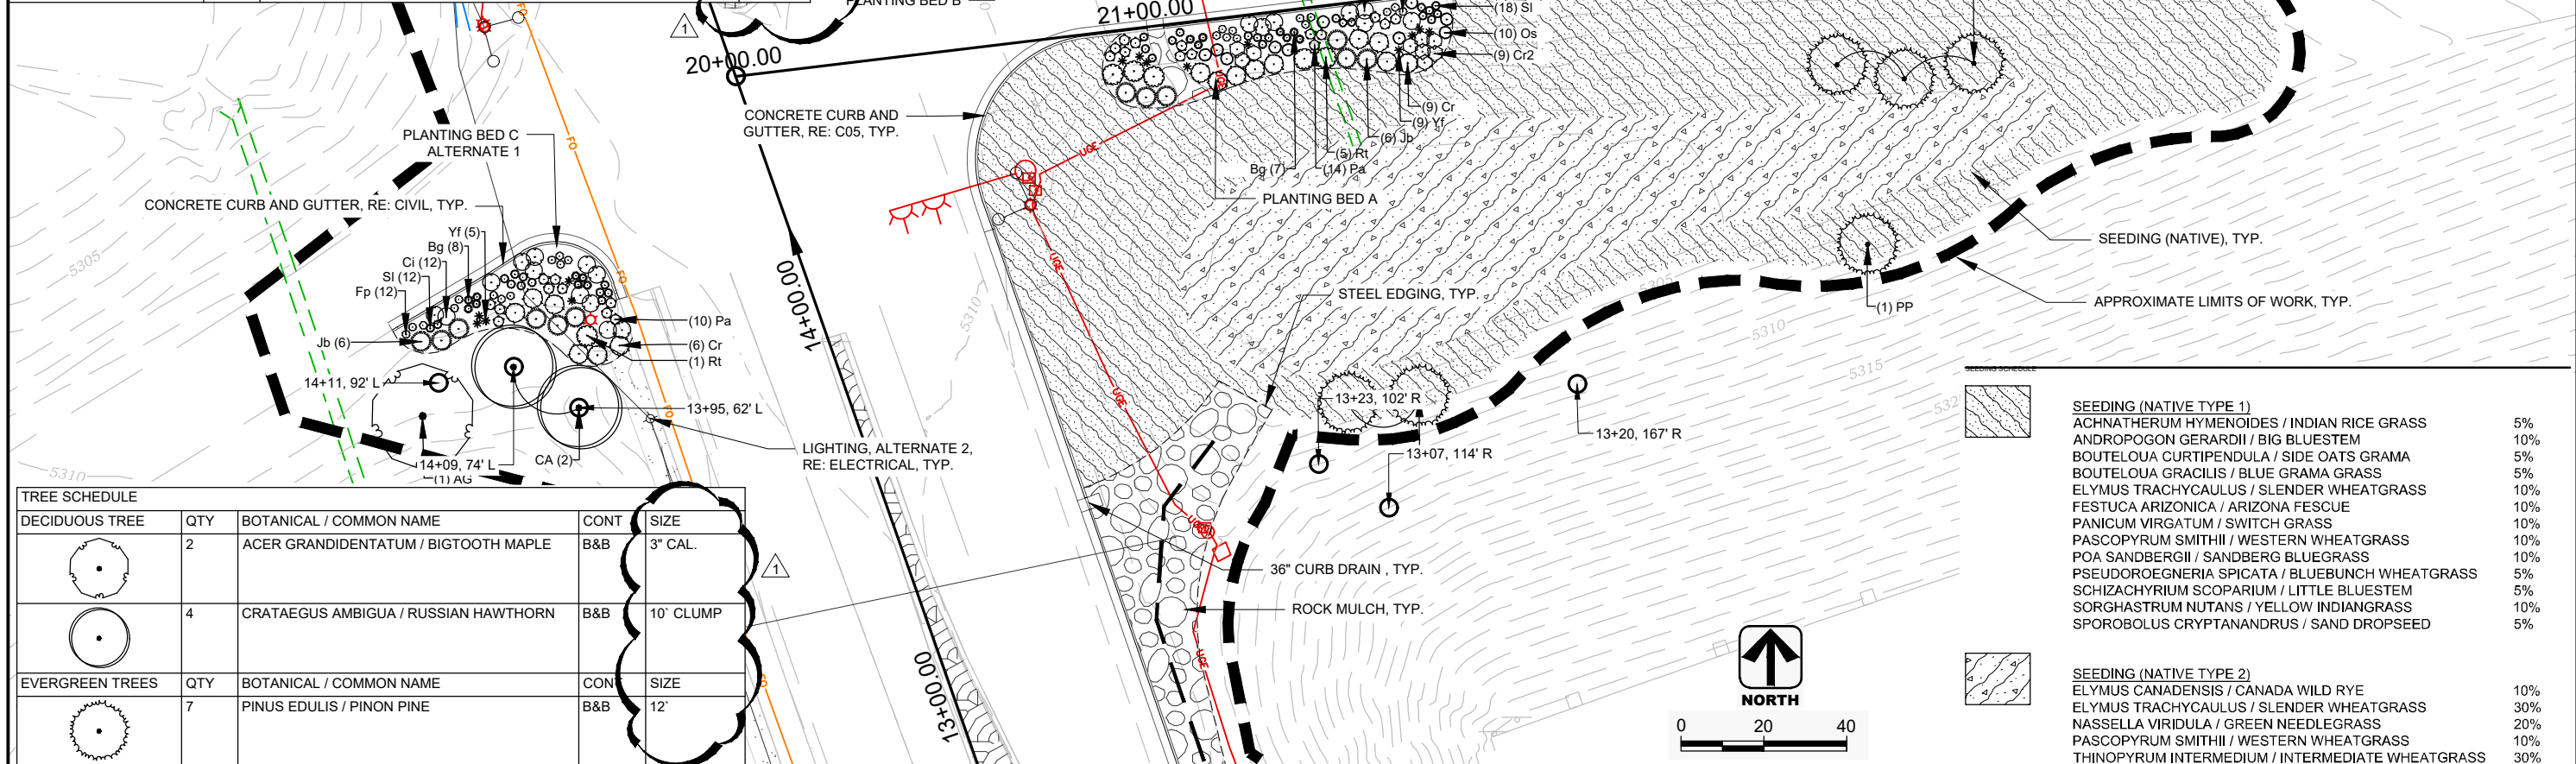

SEEDING (NATIVE TYPE 1)		
ACHNATHERUM HYMENOIDES / INDIAN RICE GRASS	5%	
ANDROPOGON GERARDII / BIG BLUESTEM	10%	
BOUTELOUA CURTIPENDULA / SIDE OATS GRAMA	5%	
BOUTELOUA GRACILIS / BLUE GRAMA GRASS	5%	
ELYMUS TRACHYCAULUS / SLENDER WHEATGRASS	10%	
FESTUCA ARIZONICA / ARIZONA FESCUE	10%	
PANICUM VIRGATUM / SWITCH GRASS	10%	
PASCOPYRUM SMITHII / WESTERN WHEATGRASS	10%	
POA SANDBERGII / SANDBERG BLUEGRASS	10%	
PSEUDOROEGNERIA SPICATA / BLUEBUNCH WHEATGRASS	5%	
SCHIZACHYRIUM SCOPARIUM / LITTLE BLUESTEM	5%	
SORGHASTRUM NUTANS / YELLOW INDIANGRASS	10%	
SPOROBOLUS CRYPTANANDRUS / SAND DROPSEED	5%	

SEEDING (NATIVE TYPE 2)		
ELYMUS CANADENSIS / CANADA WILD RYE	10%	
ELYMUS TRACHYCAULUS / SLENDER WHEATGRASS	30%	
NASSELLA VIRIDULA / GREEN NEEDLEGRASS	20%	
PASCOPYRUM SMITHII / WESTERN WHEATGRASS	10%	
THINOPYRUM INTERMEDIUM / INTERMEDIATE WHEATGRASS	30%	

Print Date: 8/9/2021
 File Name: PLANTING.DWG
 Horiz. Scale: As Noted Vert. Scale: As Noted
 Unit Information Unit Leader Initials

Sheet Revisions		
Date:	Comments	Init.
8/10/2021	ADDENDUM 1	1

The City of Rifle, COLORADO

202 Railroad Ave, Rifle, CO 81650 (970) 665-6559

As Constructed
 No Revisions:
 Revised:
 Void:

LANDSCAPE PLAN ENLARGEMENT			
Designer:	TAR	Structure	NA
Detailer:	TAR	Numbers	NA
Sheet Subset:	NA	Subset Sheets:	15 of 24

Project No. NA
 Sheet Number C07

