


LEGEND:

- SS SANITARY SEWER
- - - CULVERT
- OHE OVERHEAD ELECTRIC
- - - UGE UNDERGROUND ELECTRIC
- W WATER
- - - IRR IRRIGATION
- FO FIBER OPTIC
- SANITARY SEWER MANHOLE
- STORM MANHOLE
- ELECTRIC METER
- ELECTRIC BOX
- ELECTRIC GROUND POLE
- ⊕ ELECTRIC MANHOLE
- ELECTRIC TRANSFORMER OR VAULT
- ELECTRIC POLE
- ELECTRIC LIGHT
- TRAFFIC SIGNAL ARM
- ⊕ WATER VALVE
- ⊕ FIRE HYDRANT
- ⊕ IRRIGATION VALVE
- ⊕ TELEPHONE MANHOLE
- ⊕ TELEPHONE OR FIBER OPTIC PEDESTAL OR VAULT
- SEEDING TYPE 1 (NATIVE)
- SEEDING TYPE 2 (NATIVE)
- ROCK MULCH (RIVER COBBLE)
- CONCRETE MEDIAN COVER
- PLANTING BED (LANDSCAPE FABRIC, MULCH AND PLANTINGS)
- SOD

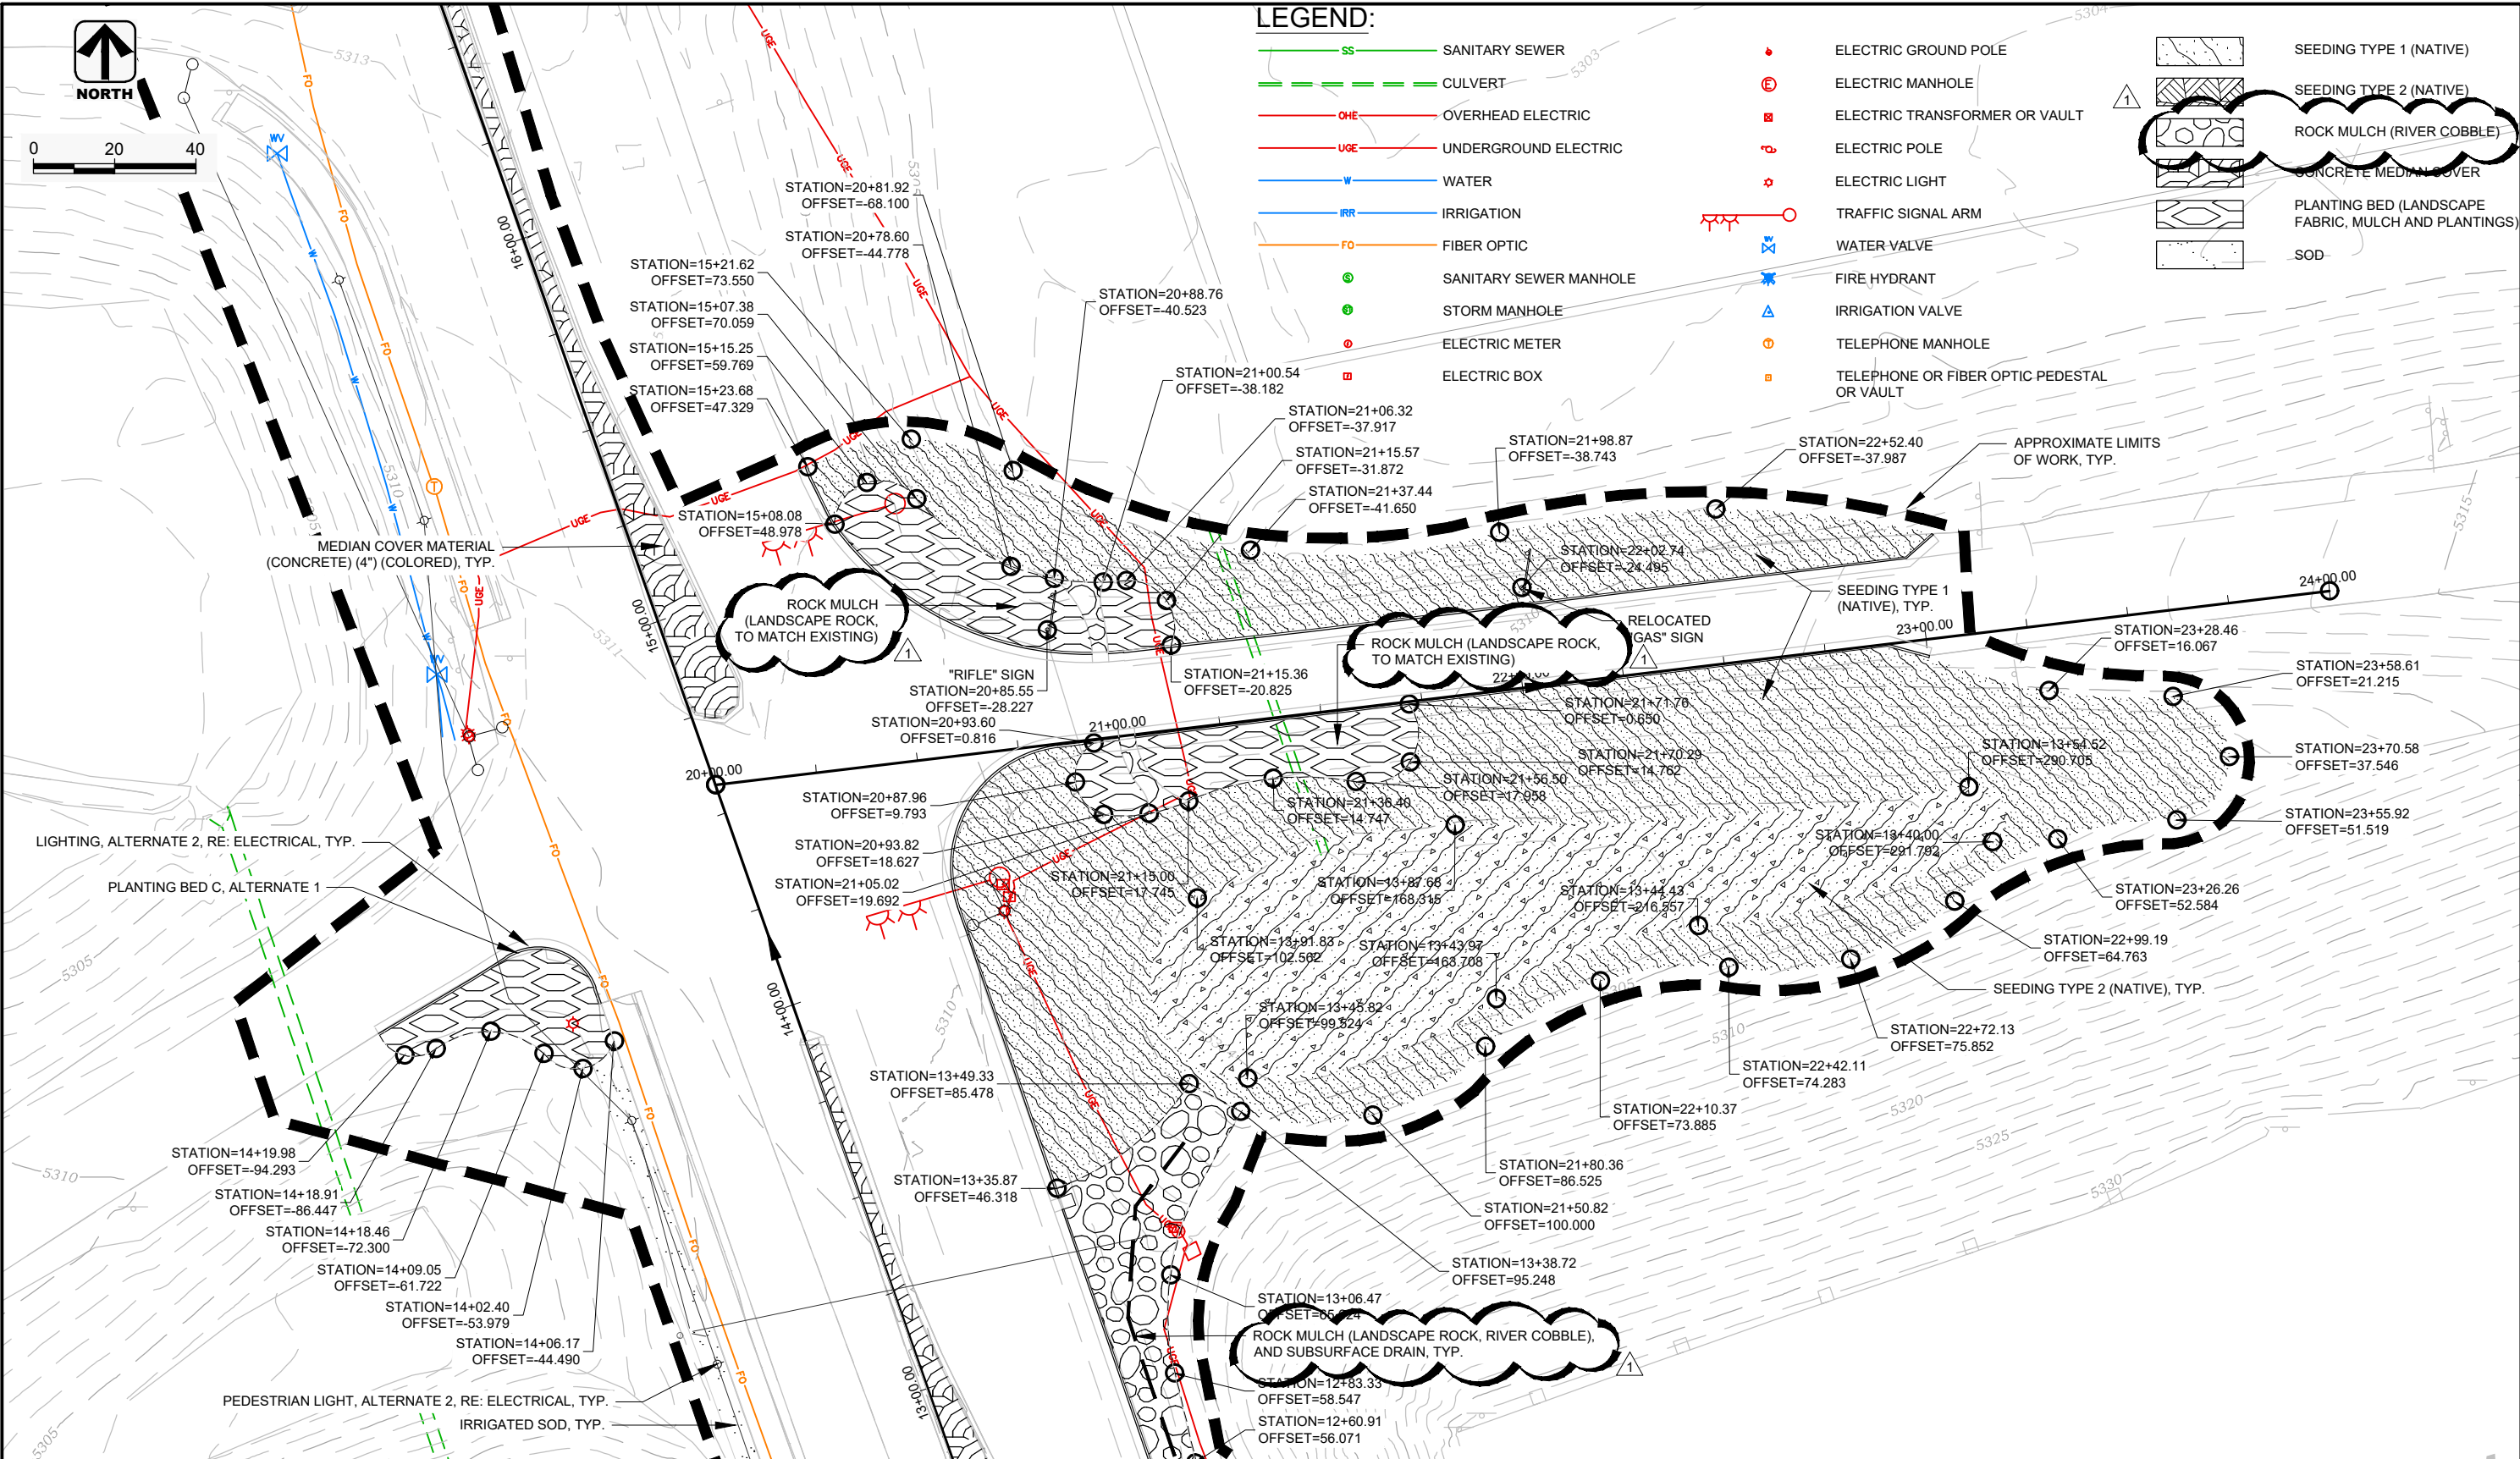

Print Date: 8/9/2021		Sheet Revisions	As Constructed	LAYOUT AND MATERIALS PLAN ENLARGEMENT		Project No.
File Name: LAYOUT.DWG		Date: 8/10/2021	No Revisions:	Designer: TAR Structure: NA Detailer: TAR Numbers: NA Sheet Subset: NA Subset Sheets: 13 of 24		.
Horiz. Scale: As Noted	Vert. Scale: As Noted	Comments: ADDENDUM 1	Revised:			NA
Unit Information	Unit Leader Initials	Init.: 1	Void:			NA
AVRES		 202 Railroad Ave, Rifle, CO 81650 (970) 665-6559				Sheet Number C05